## DUAL OCCUPANCY (DETACHED) & SWIMMING POOL

## NEW DWELLING + SECONDARY DWELLING -

ΑT

865 BROKEN HEAD RD BROKEN HEAD, BROKEN HEAD

FOR

STEHNBUILD

## **DEVELOPMENT APPLICATION**

DRAWING	SCALE	
ID	Layout Name	Rev
DA.0.01	COVER PAGE & DRAWING SCHEDULE	04
DA 1.01	EXISTING SURVEY	04
DA 1.02	PROPOSED SITE PLAN	04
DA 1.03	PRECINCT PLAN	04
DA 2.01	PROPOSED DWELLING - GROUND FLOOR PLAN	04
DA 2.02	PROPOSED DWELLING - FIRST FLOOR PLAN	04
DA 2.03	PROPOSED DWELLING - BASEMENT PLAN	04
DA 2.0 <del>←</del> 5	PROPOSED DWELLING - ROOF PLAN	04
DA 2.0 <del>5</del> 6	PROPOSED <del>SECONDARY</del> DWELLING - FLOOR PLAN	04
DA 2.0 <del>6-</del> 7	PROPOSED SECONDARY DWELLING - ROOF PLAN	04
DA 3.01	ELEVATIONS - PROPOSED DWELLING	04
DA 3.02	ELEVATIONS - PROPOSED DWELLING	04
DA 3.03	ELEVATIONS - <del>SECONDARY</del> DWELLING	04
DA 4.01	SECTIONS - PROPOSED DWELLING	04
DA 4.02	SECTIONS - PROPOSED DWELLING	04
DA 4.03	SECTIONS - SECONDARY DWELLING	04

## COMPLIANCE WITH BASIX REQUIREMENTS AS DETAILED IN THE BASIX CERTIFICATE N#: 1221524M\_02 NATHERS N#: HR - XUJXDE-01 8th July, 2021

ALL WORKS TO COMPLY WITH BASIX REQUIREMENTS AS DETAILED IN THE BASIX CERTIFICATE, INCLUDING BUT NOT LIMITED TO:

#### Rainwater Tank

Each dwelling must install a rainwater tank with a minimum size of 20,000L, and be installed in accordance with the BASIX Certificate. Each system must be configured to collect run-off from at least 130sm of roof area as specified.

#### **Swimming Pool**

The swimming pool must be outdoors and not have a volume greater than 113KL. A timer must also be installed to the pool pump.

#### **Hot Water**

The applicant must install solar (electric boosted) Hot water system to all dwellings.

#### **Natural Lighting**

Window and/or skylights must be fitted to kitchen and bathrooms achieve natural light as specified by the BASIX Certificate.

#### Alternative Energy

A photovoltaic system of at least 10kW must be installed and connected to each dwelling's electrical system as specified in the BASIX certificate.

#### Thermal Comfort

The applicant must construct the development in accordance with all thermal performance specifications set out in the Assessor Certificate.

#### Floor and Wall Construction

The applicant must construct the floors and walls of the dwelling in accordance with the specifications listed on the Assessor certificate.






All building works to be carried out in accordance with the
Building Code of Australia (BCA) and to the satisfaction of the
principle certifying authority. Builders/Contractors are to verify all
dimensions prior to commencement of site work or off-site
fabrication. Figured dimensions take precedence - do not scale.
Copyright HARLEY GRAHAM ARCHITECTS

	Issue Name	Issue ID	Issue Date	
L.	DRAFT DA	01	3/3/21	
	REVISED DA - As per bushfire advice	02	9/6/21	
J	REVISED DA - As per Consultant advice	03	29/6/21	
-	FINAL DA - Issued for lodgement	04	8/7/21	
ŀ				
.,(				

							AK LAI DLAI AICIA	1 - 1/1/04
ne	NEW DWELLING	, OEOONDAR	¥ 865 BF	ROKEN HEAD RD		SHEET TITLE		APPROVED
	DWELLING AND			BROKEN HEAD		COVER PAGE & DRAWING SC	HEDULE	HG
ce	JOB NAME			ADDRESS				110
nt	HGA266	LOT 8	DP 840653		PAPER	DWG NO.	STATUS	REV
$\exists$	JOB NO.	LOT + DP		SCALE.	A3	DA.0.01	NOT FOR CONSTRUCTION	04

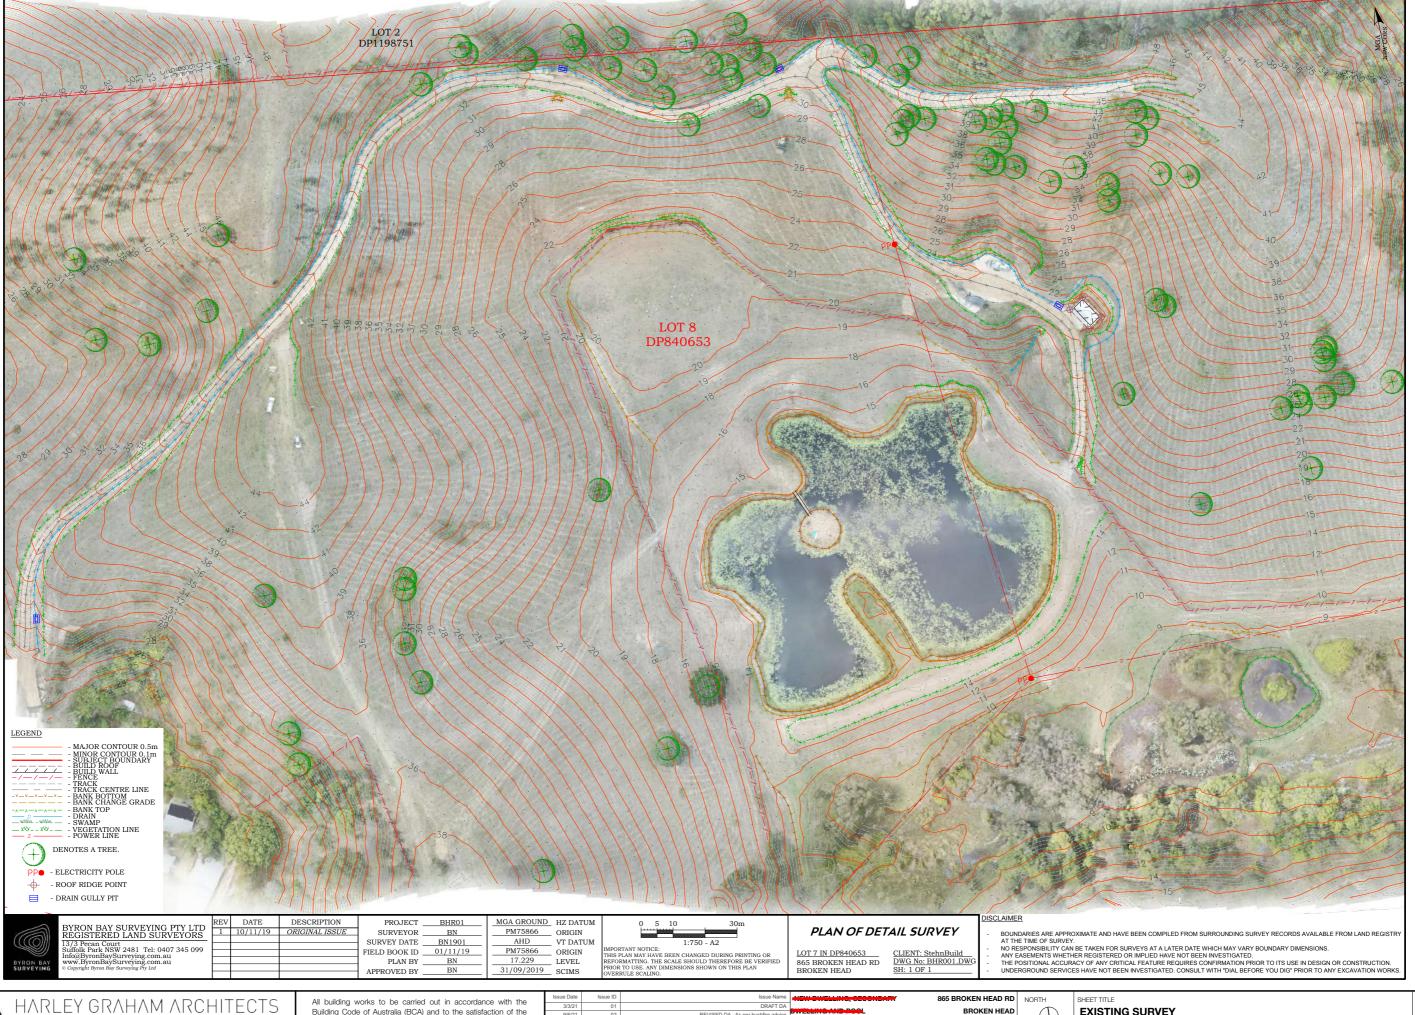



LVL 1/144 JOHNSON STREET BYRON BAY | PO BOX 1285 NSW 2481 F: 02 66809820 | T: 02 66809690 | E: office@harleygraham.com ABN: 85158246003 NSW 7892


Building Code of Australia (BCA) and to the satisfaction of the principle certifying authority. Builders/Contractors are to verify all dimensions prior to commencement of site work or off-site fabrication. Figured dimensions take precedence - do not scale.

© Copyright HARLEY GRAHAM ARCHITECTS

JOB NAME

BROKEN HEAD ADDRESS HGA266 LOT 8 DP 840653

**EXISTING SURVEY** HG NOT FOR CONSTRUCTION DA 1.01

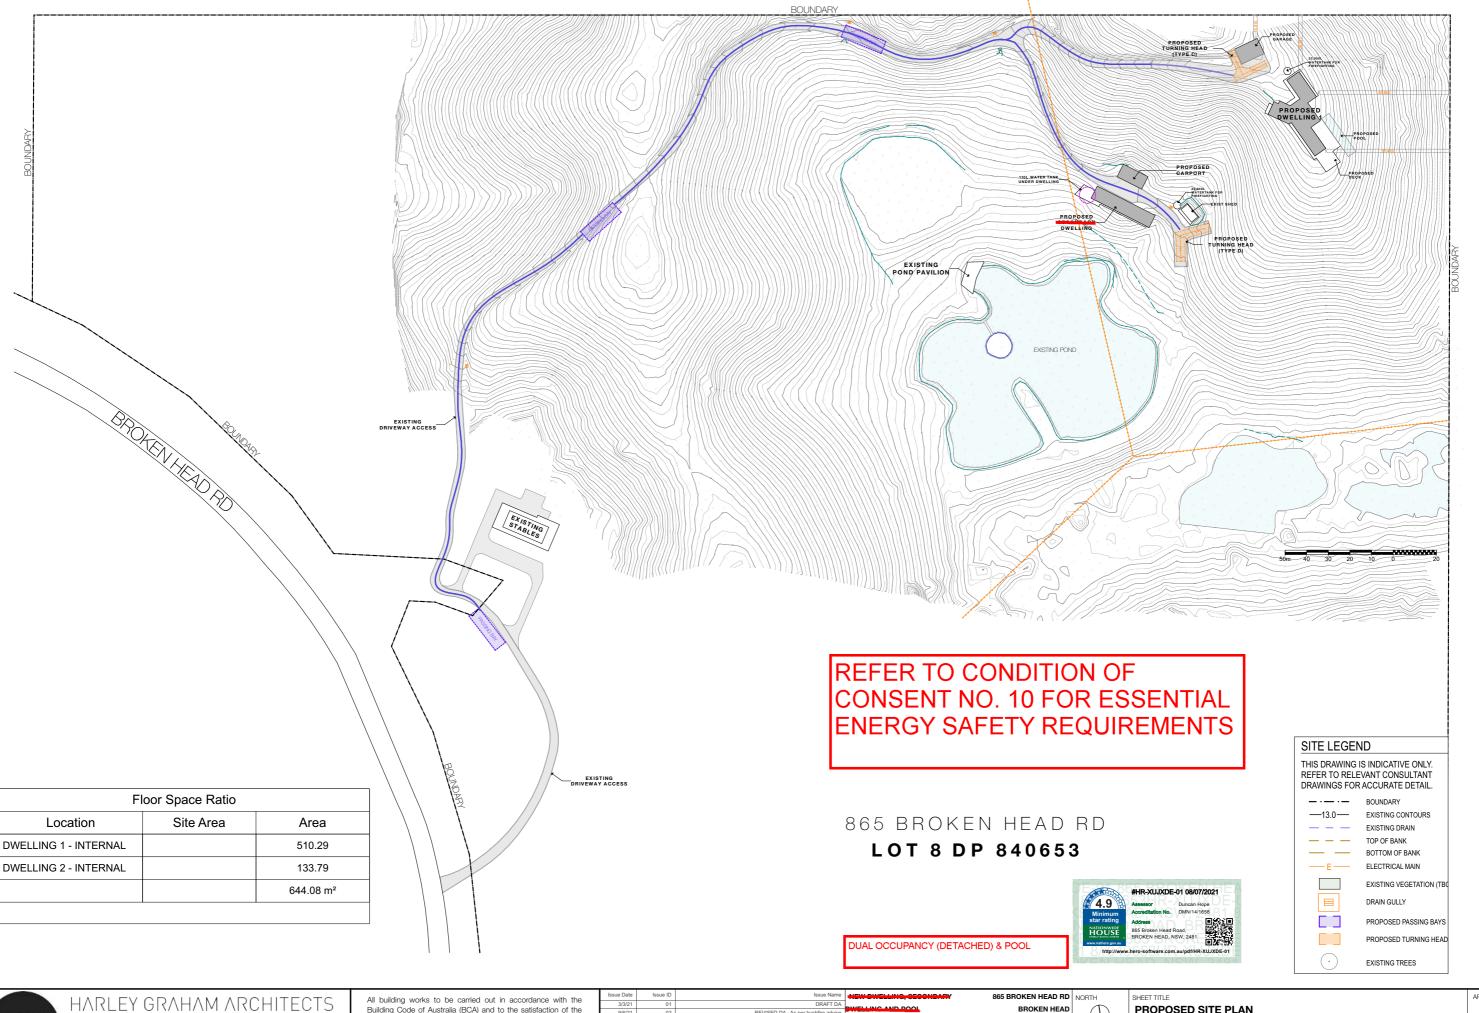



LVL 1/144 JOHNSON STREET BYRON BAY | PO BOX 1285 NSW 2481 F: 02 66809820 | T: 02 66809690 | E: office@harleygraham.com ABN: 85158246003 NSW 7892

Building Code of Australia (BCA) and to the satisfaction of the principle certifying authority. Builders/Contractors are to verify all dimensions prior to commencement of site work or off-site fabrication. Figured dimensions take precedence - do not scale. © Copyright HARLEY GRAHAM ARCHITECTS


-	Issue Name	Issue ID	Issue Date	ļ
L	DRAFT DA	01	3/3/21	
	REVISED DA - As per bushfire advice	02	9/6/21	
JOB I	REVISED DA - As per Consultant advice	03	29/6/21	
$\vdash$	FINAL DA - Issued for lodgement	04	8/7/21	
∣HG				
1				
IOR				


HGA266	LOTO	DP 840653	1:1750
JOB NAME	_		ADDRESS
WELLING AND	POOL		BROKEN HEAD
NEW DWELLING	, OECONDA	RY 865 B	ROKEN HEAD RD

RD AD	NORTH	PF
	PAPER	DWG
	Δ3	DA

ROPOSED SITE PLAN 3 NO. NOT FOR CONSTRUCTION DA 1.02


HG

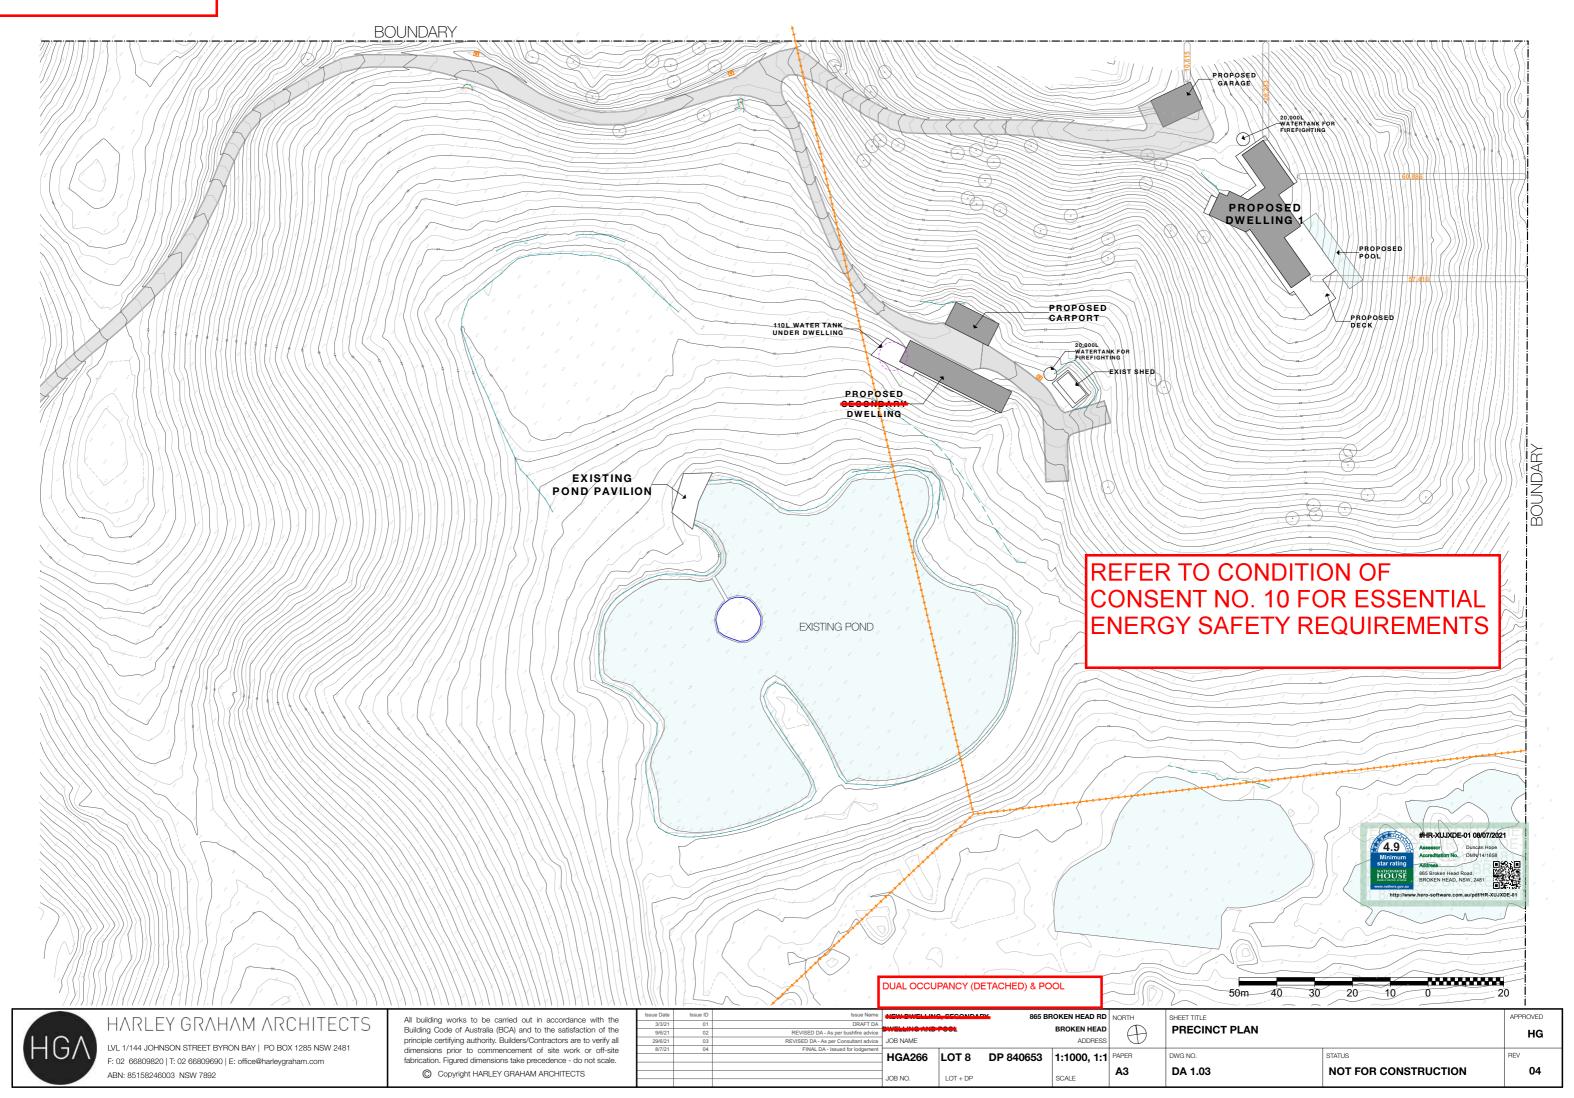

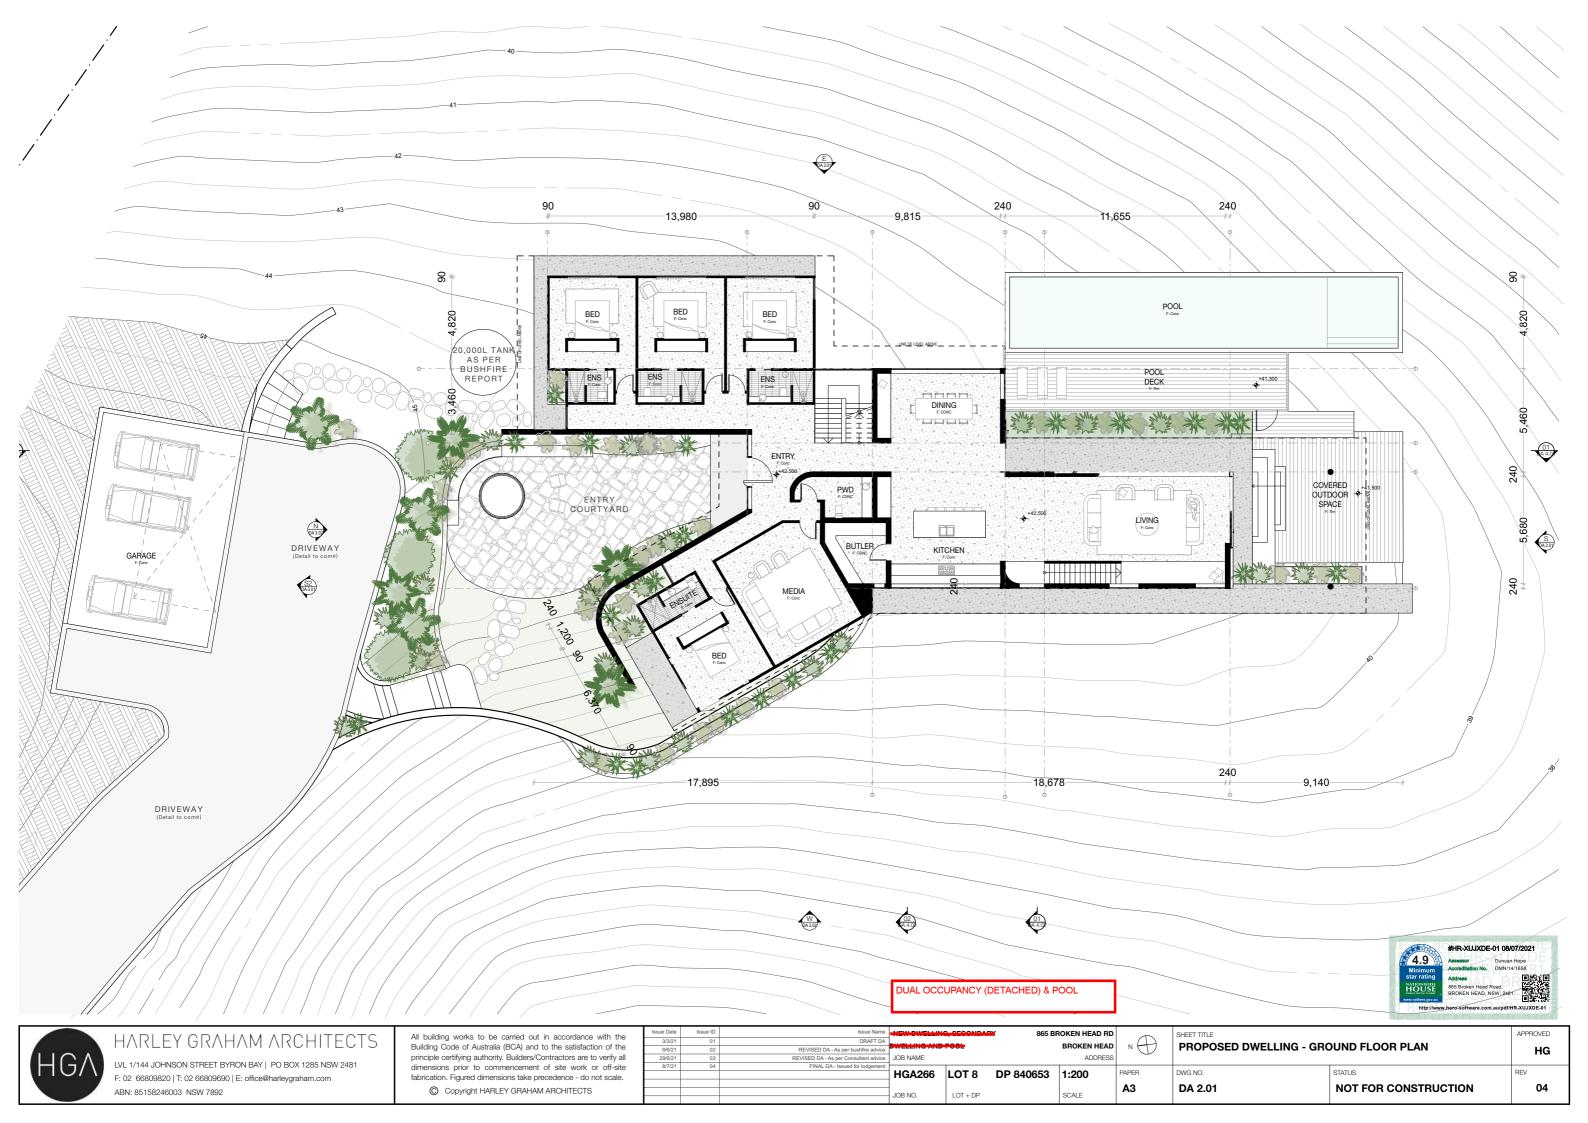





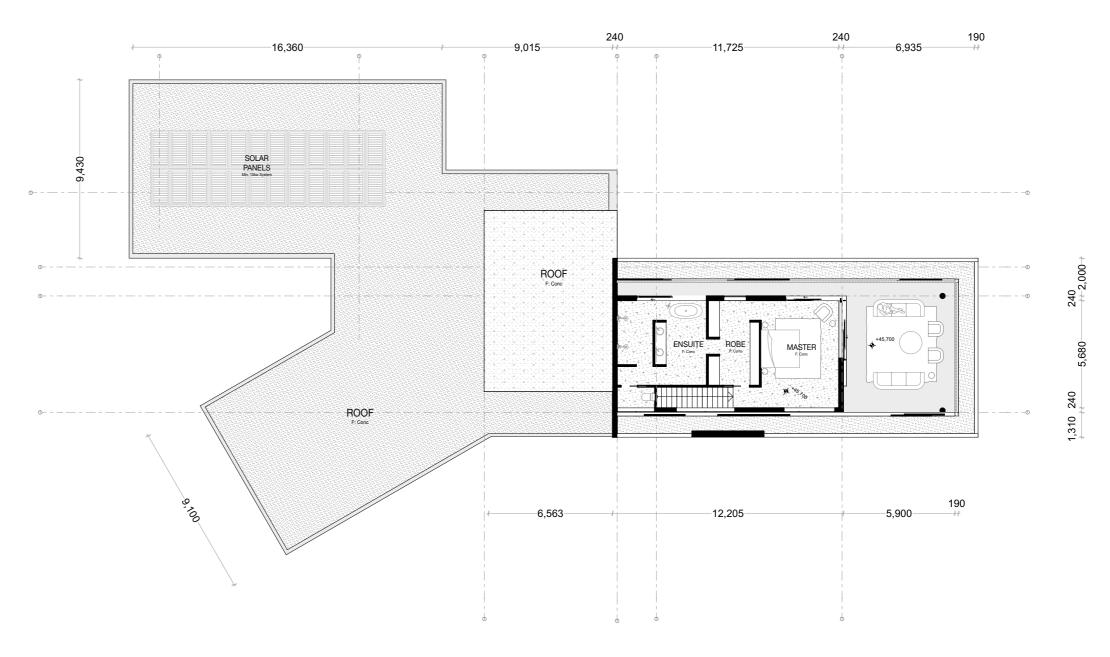









#### DUAL OCCUPANCY (DETACHED) & POOL





ABN: 85158246003 NSW 7892


ROOF F. Conc


-11211	Issue Name	Issue ID	Issue Date	
	DRAFT DA	01	3/3/21	
DWLL	REVISED DA - As per bushfire advice	02	9/6/21	
JOB N	REVISED DA - As per Consultant advice	03	29/6/21	
	FINAL DA - Issued for lodgement	04	8/7/21	
HG				
l				


	JOB NAME	,	₩ 865 BF	ROKEN HEAD RD BROKEN HEAD ADDRESS	N $\bigoplus$	SHEET TITLE PROPOSED DWELLING - FIRS	ST FLOOR PLAN	APPR	HG
1	HGA266	LOT 8	DP 840653	1:200	PAPER	DWG NO.	STATUS	REV	
1	JOB NO.	LOT + DP		SCALE	A3	DA 2.02	NOT FOR CONSTRUCTION		04

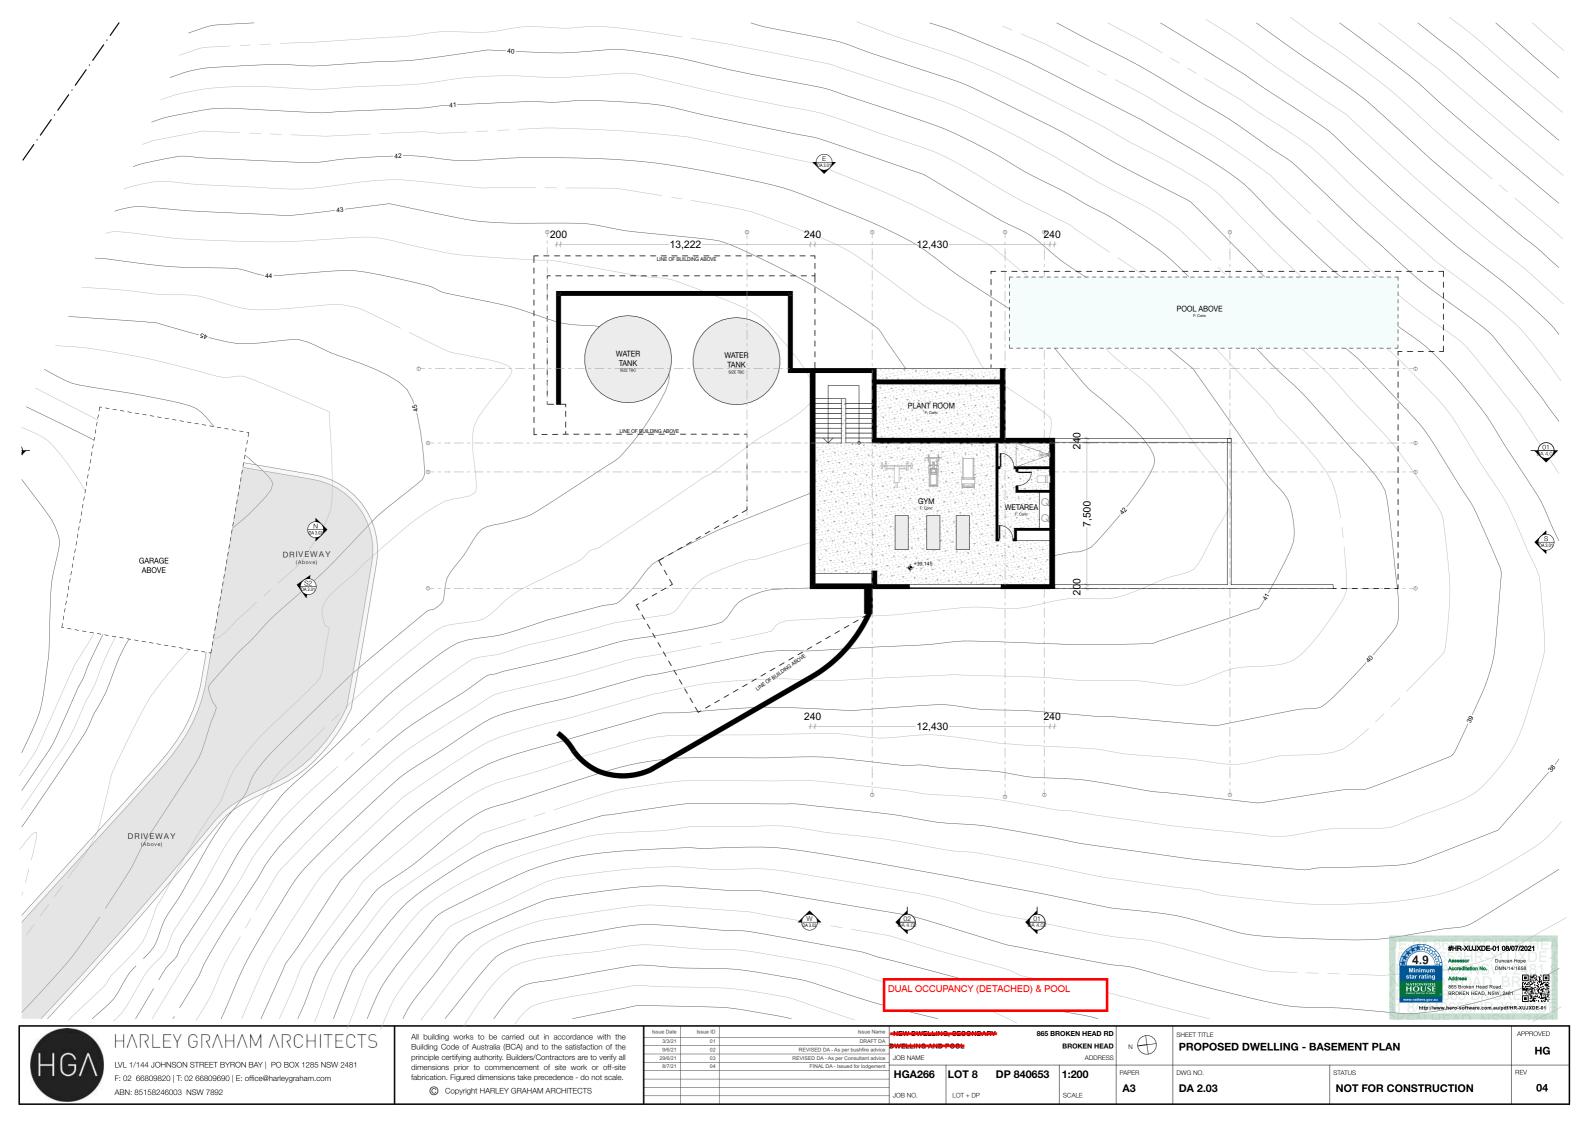

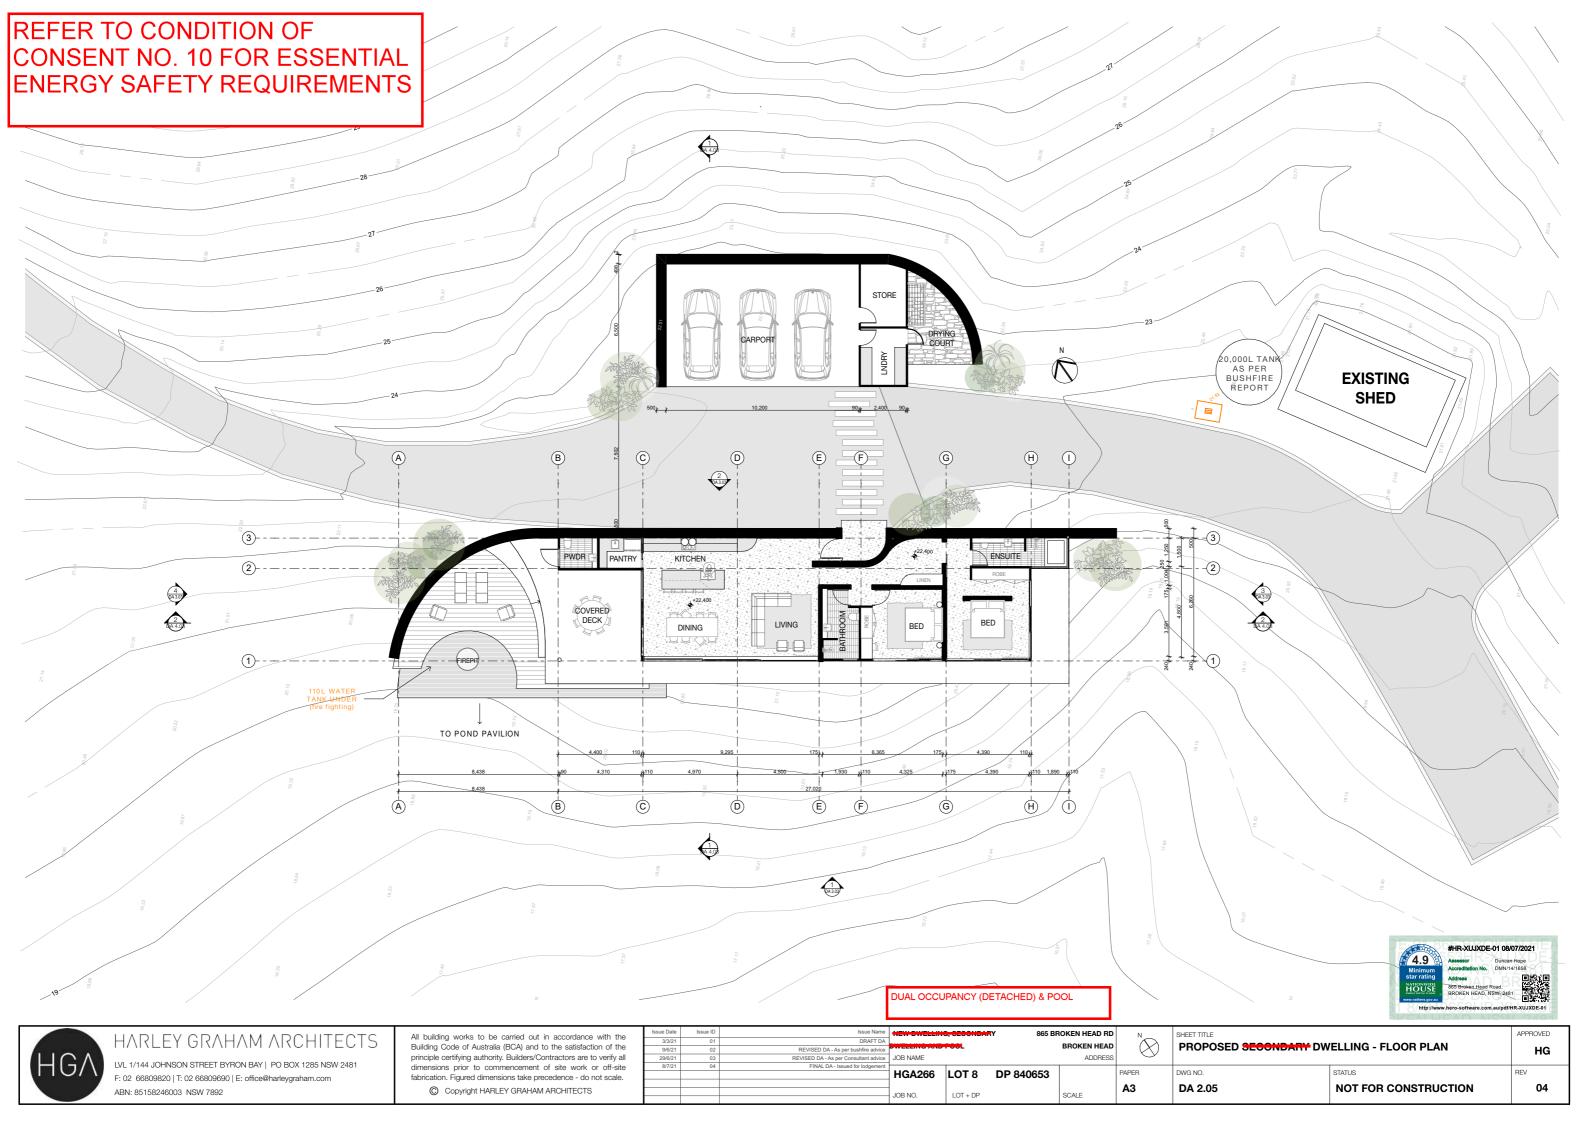

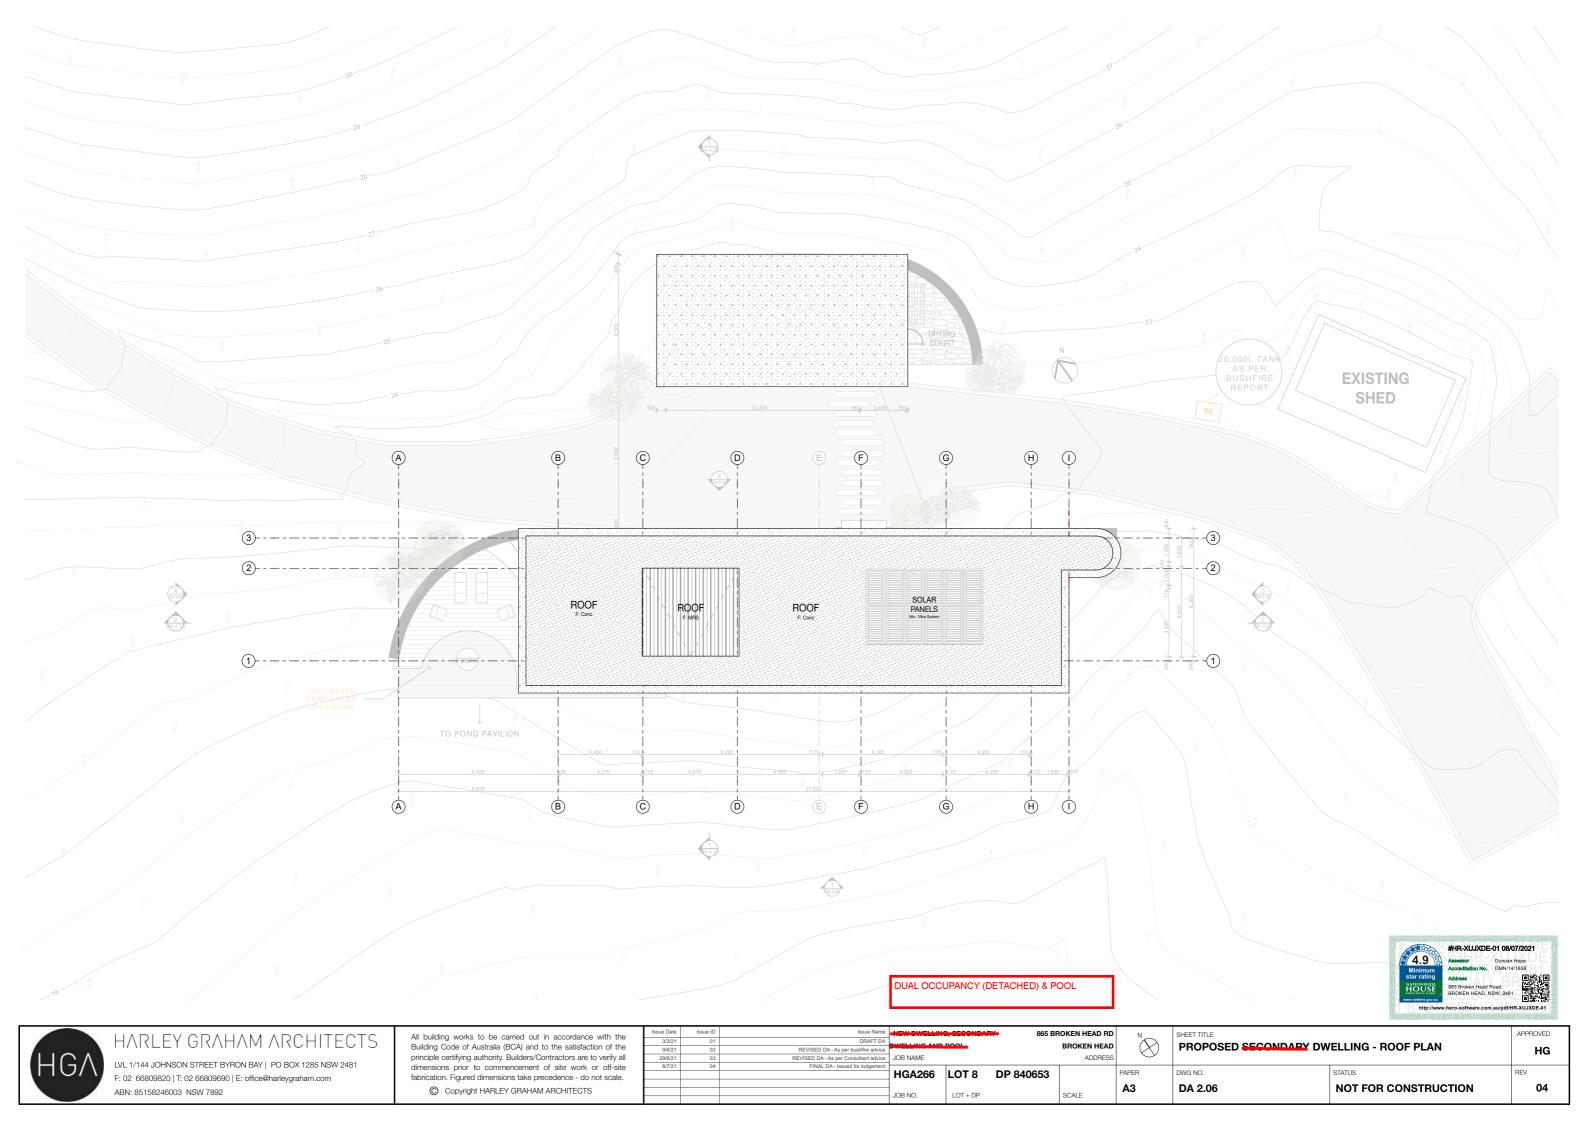

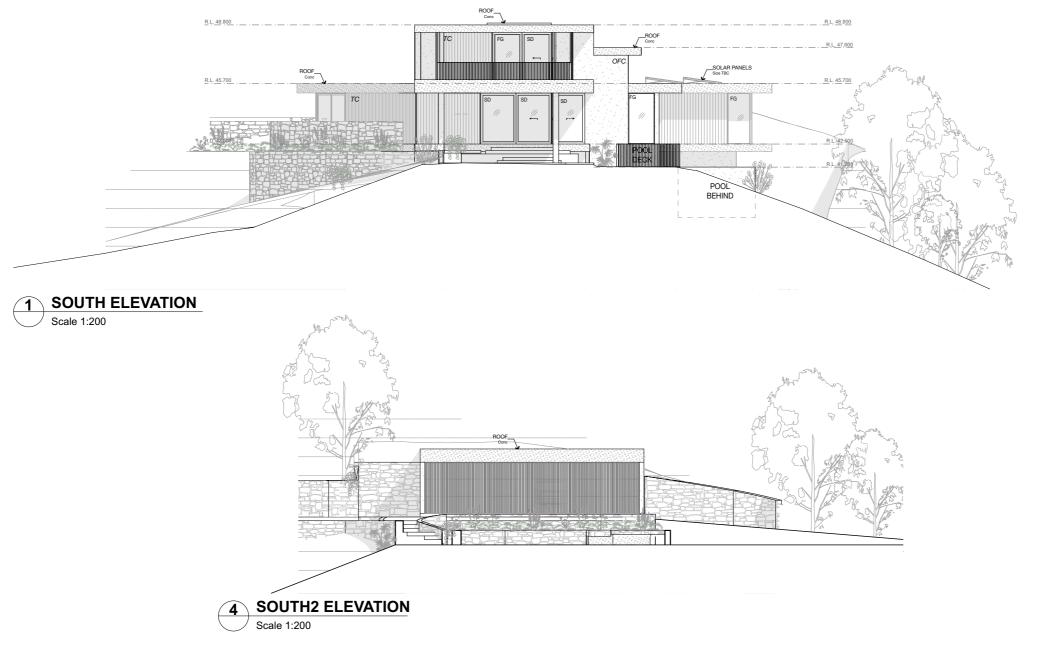

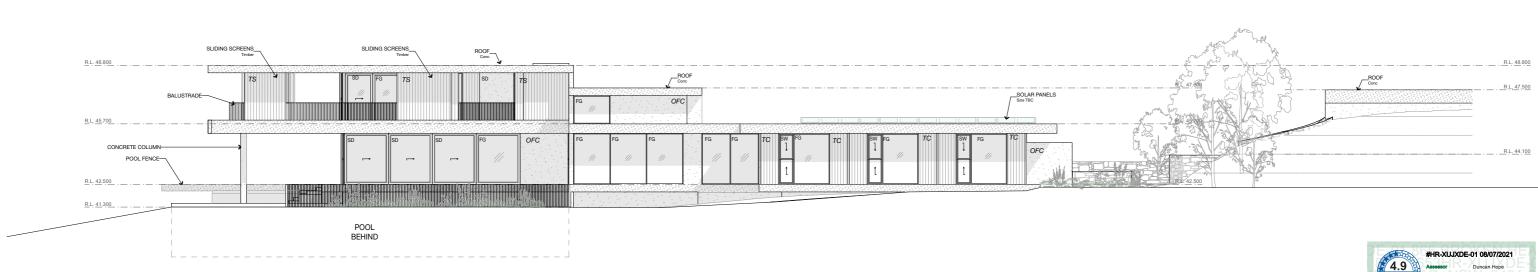



Scale 1:200

**EAST ELEVATION** 

## HARLEY GRAHAM ARCHITECTS

LVL 1/144 JOHNSON STREET BYRON BAY | PO BOX 1285 NSW 2481 F: 02 66809820 | T: 02 66809690 | E: office@harleygraham.com ABN: 85158246003 NSW 7892

All building works to be carried out in accordance with the Building Code of Australia (BCA) and to the satisfaction of the principle certifying authority. Builders/Contractors are to verify all dimensions prior to commencement of site work or off-site fabrication. Figured dimensions take precedence - do not scale. © Copyright HARLEY GRAHAM ARCHITECTS

NEW DW	Issue Name	Issue ID	Issue Date	
-	DRAFT DA	01	3/3/21	
	REVISED DA - As per bushfire advice	02	9/6/21	
JOB NAME	REVISED DA - As per Consultant advice	03	29/6/21	
1	FINAL DA - Issued for lodgement	04	8/7/21	
HGA2				
]				
JOB NO.				

ıme	NEW DWELLIN	G, SECONDA	865 BF	ROKEN HEAD RD	Γ
DA	DWELLING AND			BROKEN HEAD	
vice		TOOL			
vice	JOB NAME			ADDRESS	
nent					Ť.
	HGA266	LOT 8	DP 840653	1:200	ľ

SCALE

DUAL OCCUPANCY (DETACHED) & POOL

LOT + DP

		OTILLI TITLL
AD		<b>ELEVATIONS - PR</b>
ESS		
	PAPER	DWG NO.
	A3	DA 3.01

DA 3.01	NOT FOR CONSTRUCTION		04		
DWG NO.	STATUS	REV			
ELEVATIONS - PROPOSED DWELLING					
SHEET TITLE		APPE	OVED		

MATERIALS

MWS BRK

TL

VJ

CFC

FC OFC

PB PCC

SCW ТВ

тс TD

TS

VB

WB

GL

ST

GV

PV

СВ

HDG MT

PC

PF

RF

ST

WT

**FINISHES** 

METAL ROOF SHEETING METAL WALL SHEETING

ALUMINIUM CLADDING

OFF-FORM CONCRETE PLASTERBOARD

COMPRESSED FIBRE CEMENT

POLY CARBONATE CLADDING SPRAYED CONCRETE WALL (SHOTCRETE)

BRICKWORK

FIBRE CEMENT

TIMBER BATTENS

TIMBER CLADDING

TIMBER DECKING

WEATHERBOARD

VILLABOARD

GLAZING

STONE

GRAVEL

PAVING

ANODISED

COLORBOND HOT DIP GALVANISED

MOSAIC TILE

POWDER COAT

RENDER FINISH SEALANT


NATURAL STONE

WALL TILE

PAINT FINISH

TIMBER SCREEN (SLIDING)

TILE VJ CLADDING

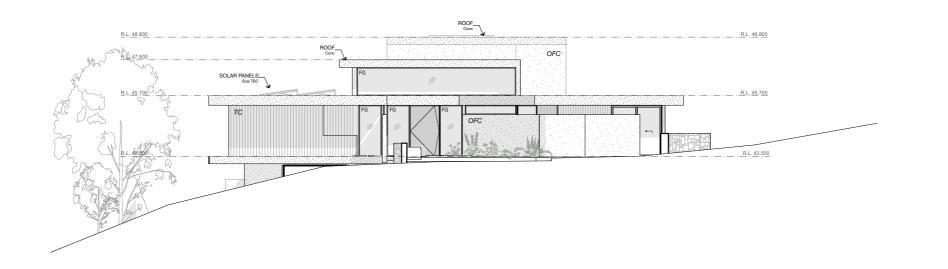





Scale 1:200

DUAL OCCUPANCY (DETACHED) & POOL



MATERIALS

MWS BRK

VJ

CFC

FC

OFC

PB

PCC

SCW

TC

TS

VB

GL

ST

GV

PV

СВ

HDG

MT

PC

PF

RF

ST

WT

**FINISHES** 

METAL ROOF SHEETING
METAL WALL SHEETING

COMPRESSED FIBRE CEMENT

POLY CARBONATE CLADDING

SPRAYED CONCRETE WALL (SHOTCRETE)

TIMBER SCREEN (SLIDING)

BRICKWORK TILE

VJ CLADDING ALUMINIUM CLADDING

FIBRE CEMENT

TIMBER BATTENS
TIMBER CLADDING

TIMBER DECKING

VILLABOARD WEATHERBOARD

GLAZING

STONE

GRAVEL

PAVING

ANODISED

COLORBOND

MOSAIC TILE

POWDER COAT

PAINT FINISH

RENDER FINISH

NATURAL STONE

WALL TILE

HOT DIP GALVANISED

OFF-FORM CONCRETE
PLASTERBOARD

	HARLEY GRAHAM ARCHITECTS
(HGA)	LVL 1/144 JOHNSON STREET BYRON BAY   PO BOX 1285 NSW 2481
110/1	F: 02 66809820   T: 02 66809690   E: office@harleygraham.com

ABN: 85158246003 NSW 7892


All building works to be carried out in accordance with the Building Code of Australia (BCA) and to the satisfaction of the principle certifying authority. Builders/Contractors are to verify all dimensions prior to commencement of site work or off-site fabrication. Figured dimensions take precedence - do not scale.

NORTH ELEVATION

Scale 1:200


NEW	Issue Name	Issue ID	Issue Date	
	DRAFT DA	01	3/3/21	
	REVISED DA - As per bushfire advice	02	9/6/21	
JOB N	REVISED DA - As per Consultant advice	03	29/6/21	
<u> </u>	FINAL DA - Issued for lodgement	04	8/7/21	
HG				
JOB N				

ŀ	NEW DWELLING	SECONDA	≥¥ 865 BF	ROKEN HEAD RD		SHEET TITLE		APPROVE	:D
ł	DWELLING AND	POOL		BROKEN HEAD		ELEVATIONS - PROPOSED DWELLING		HG	
1	JOB NAME			ADDRESS				• • • • • • • • • • • • • • • • • • • •	۵.
1	HGA266	LOT 8	DP 840653	1:200	PAPER	DWG NO.	STATUS	REV	
-	JOB NO.	LOT + DP		SCALE	А3	DA 3.02	NOT FOR CONSTRUCTION	04	1

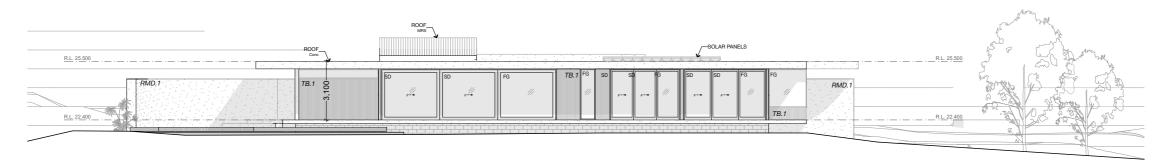


## 1 SOUTH/WEST ELEVATION


Scale 1:200

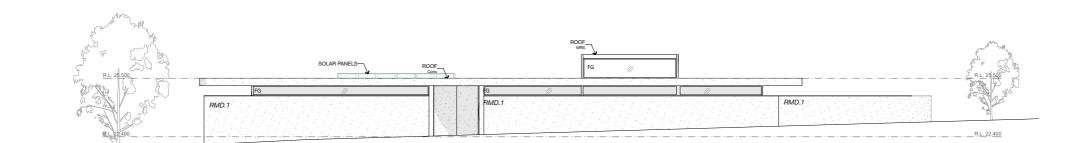

# NORTH/EAST ELEVATION Scale 1:200

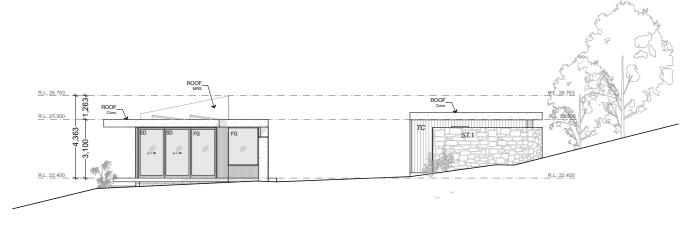

3 SOUTH/EAST ELEVATION
Scale 1:200

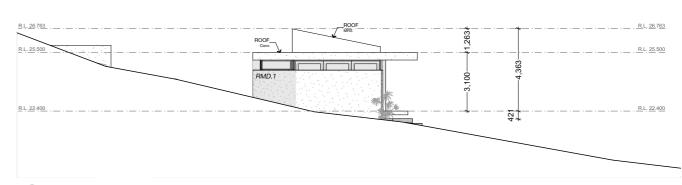

WEST ELEVATION
Scale 1:200

DUAL OCCUPANCY (DETACHED) & POOL

# #HR-XUJXDE-01 08/07/2021 Assessor Duncan Hope Accreditation No. DMN/14/1658 Accreditation No. DMN/14/1658 Accreditation No. DMN/14/1658 B65 Broken Head Road, BROKEN HEAD, NSW, 2481

NOT FOR CONSTRUCTION

HG

04

MATERIALS

MWS

BRK

٧J

CFC

FC

OFC

PB

PCC

RMD

TB

TC

TD

TS VB

WB

GL

ST

G۷

PV

СВ

HDG MT

PC

PF

RF

ST

WT

METAL ROOF SHEETING

METAL WALL SHEETING

COMPRESSED FIBRE CEMENT

POLY CARBONATE CLADDING

BRICKWORK TILE

VJ CLADDING ALUMINIUM CLADDING

FIBRE CEMENT

OFF-FORM CONCRETE
PLASTERBOARD

RAMMED EARTH WALL

TIMBER BATTENS

TIMBER CLADDING

TIMBER DECKING
TIMBER SCREEN (SLIDING)

WEATHERBOARD

VILLABOARD

GLAZING

STONE

GRAVEL

PAVING

ANODISED

COLORBOND HOT DIP GALVANISED

MOSAIC TILE

POWDER COAT

RENDER FINISH

NATURAL STONE

WALL TILE

PAINT FINISH


**FINISHES** 


## HARLEY GRAHAM ARCHITECTS

LVL 1/144 JOHNSON STREET BYRON BAY | PO BOX 1285 NSW 2481 F: 02 66809820 | T: 02 66809690 | E: office@harleygraham.com ABN: 85158246003 NSW 7892

NEW DW	Issue Name	Issue ID	Issue Date	
	DRAFT DA	01	3/3/21	
	REVISED DA - As per bushfire advice	02	9/6/21	
JOB NAME	REVISED DA - As per Consultant advice	03	29/6/21	
<del></del>	FINAL DA - Issued for lodgement	04	8/7/21	
HGA2				
]				
JOB NO.				

	NEW DWELLING, SEC	OONDAIN	865 BR	OKEN HEAD RD		SHEET TITLE			
BROKEN HEAD				BROKEN HEAD		ELEVATIONS - SECONDARY DWELLING			
	JOB NAME			ADDRESS					
	HGA266 LO	T8 DF	840653	1:200	PAPER	DWG NO.	STATUS		
_					A3	DA 3.03	NOT FOR		
_	JOB NO. LOT	Γ + DP	I	SCALE	_				

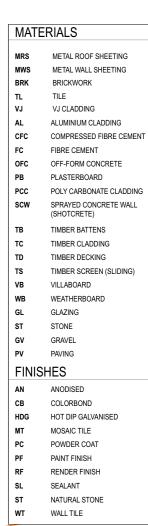

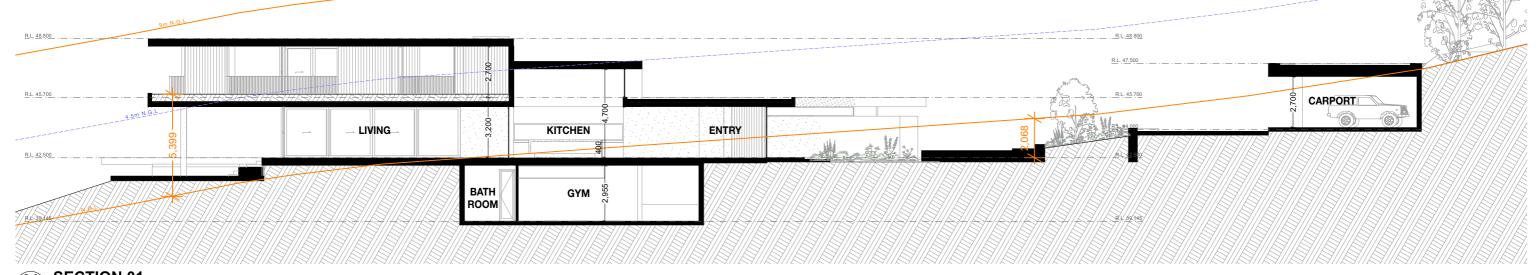

01 SECTION 01
Scale 1:200

DUAL OCCUPANCY (DETACHED) & POOL



	HARLEY GRAHAM ARCHITECT
(HGV)	LVL 1/144 JOHNSON STREET BYRON BAY   PO BOX 1285 NSW 2481


LVL 1/144 JOHNSON STREET BYRON BAY | PO BOX 1285 NSW 2481 F: 02 66809820 | T: 02 66809690 | E: office@harleygraham.com ABN: 85158246003 NSW 7892

	isodo italio	1000010	10000 Date	
	DRAFT DA	01	3/3/21	
	REVISED DA - As per bushfire advice	02	9/6/21	
JOB N	REVISED DA - As per Consultant advice	03	29/6/21	
$\vdash$	FINAL DA - Issued for lodgement	04	8/7/21	
HG/				
1				
JOB N				
1 JUD IV				

EW BWELLIN	a, cecondan	₩ 865 BF	ROKEN HEAD RD		SHEET TITLE		APPRO	OVED
ELLING AND	POOL		BROKEN HEAD		SECTIONS - PROPOSED DWE	ELLING	HG	
B NAME			ADDRESS					
IGA266	LOT 8	DP 840653	1:200	PAPER	DWG NO.	STATUS	REV	
OB NO.	LOT + DP		SCALE	A3	DA 4.01	NOT FOR CONSTRUCTION		04





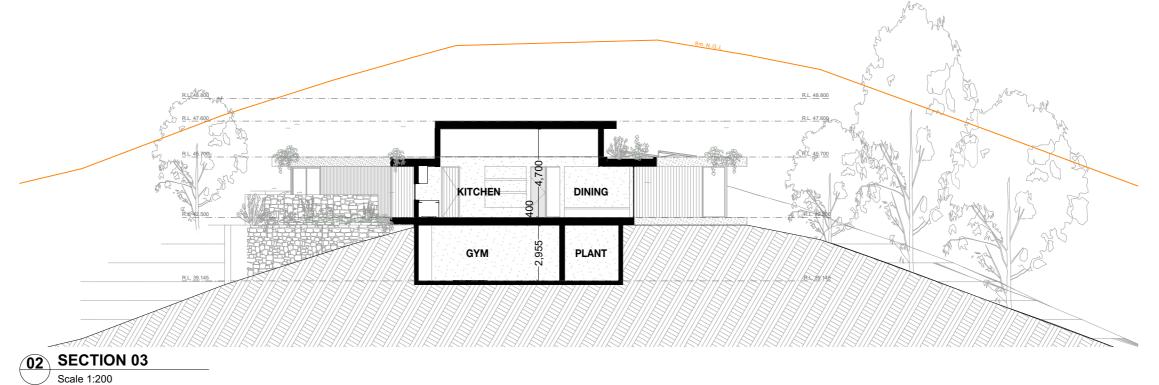

DUAL OCCUPANCY (DETACHED) & POOL



HG

04


# HARLEY GRAHAM ARCHITECTS


LVL 1/144 JOHNSON STREET BYRON BAY | PO BOX 1285 NSW 2481 F: 02 66809820 | T: 02 66809690 | E: office@harleygraham.com ABN: 85158246003 NSW 7892

Scale 1:200

-	Issue Name	Issue ID	Issue Date	
L.,	REVISED DA - As per bushfire advice	02	9/6/21	
	REVISED DA - As per Consultant advice	03	29/6/21	
JO	FINAL DA - Issued for lodgement	04	8/7/21	
.ın				

NEW BWELLING	SECONDAD	¥ 865 BF	ROKEN HEAD RD		SHEET TITLE			
WELLING AND	1001		BROKEN HEAD		SECTIONS - PROPOSED DWELLING			
JOB NAME			ADDRESS					
HGA266	LOT 8	DP 840653	1:200	PAPER	DWG NO.	STATUS		
JOB NO.	LOT + DP		SCALE	А3	DA 4.02	NOT FOR CONSTRUCTION		

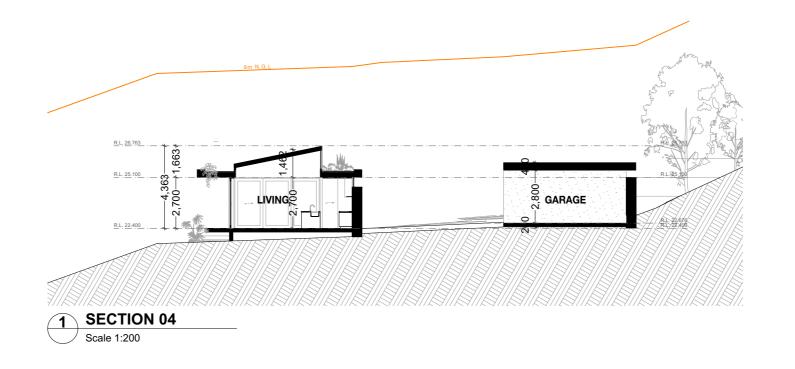

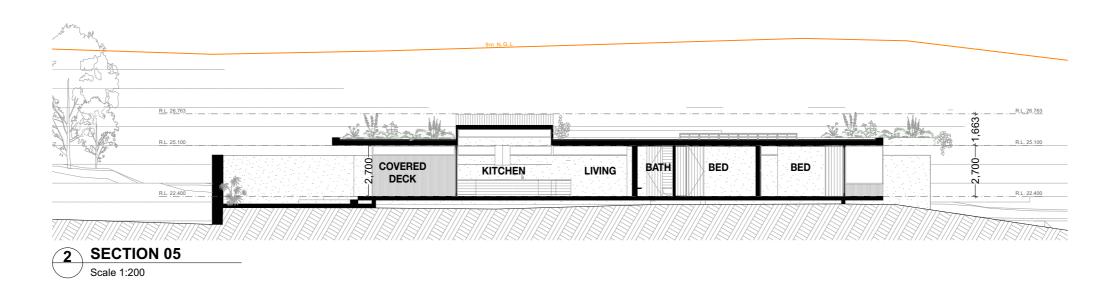








ABN: 85158246003 NSW 7892

-112	Issue Name	Issue ID	Issue Date	
L	DRAFT DA	01	3/3/21	
1	REVISED DA - As per bushfire advice	02	9/6/21	
JOB	REVISED DA - As per Consultant advice	03	29/6/21	
$\vdash$	FINAL DA - Issued for lodgement	04	8/7/21	
H				
1				
JOB				

NEW DWELLING, SECONDARY 865 BROKEN HEAD RD			ROKEN HEAD RD		SHEET TITLE SECTIONS - SECONDARY DWELLING		APPROVED
DWELLING AND POSE BROKEN HEA			BROKEN HEAD				HG
JOB NAME ADDRESS			ADDRESS				110
HGA266	LOT 8	DP 840653	1:200	PAPER	DWG NO.	STATUS	REV
JOB NO.	LOT + DP		SCALE	А3	DA 4.03	NOT FOR CONSTRUCTION	04

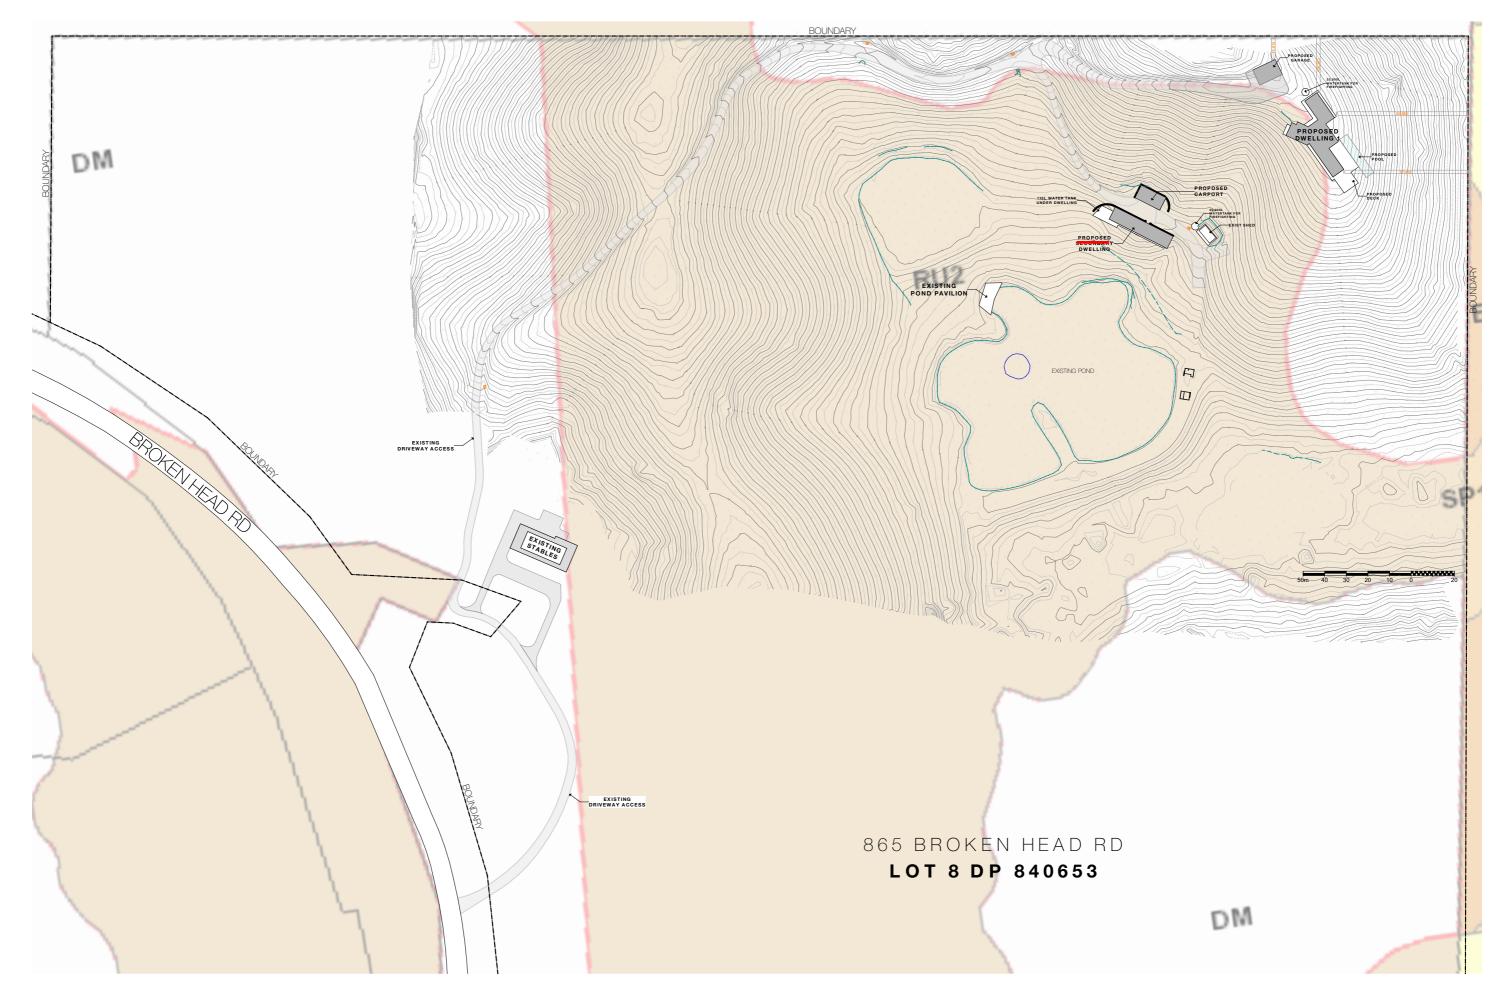



NEW	Issue Name	Issue ID	Issue Date	
<u> </u>	REVISED DA - As per bushfire advice	02	9/6/21	
PWLL	REVISED DA - As per Consultant advice	03	29/6/21	
JOB N				
HG				
JOB N				
1000			1	

W DWELLING, SECONDARY 865 BROKEN HEAD RD			ROKEN HEAD RD BROKEN HEAD	NORTH	SHEET TITLE PRECINCT PLAN - ZONING OVERLAY		APPE	ROVE
ELLING AND FOOL		DRUKEN HEAD	$\Box$	HC				
B NAME		ADDRESS	$\mathcal{L}$					
IGA266	LOT 8	DP 840653	1:1750	PAPER	DWG NO.	STATUS	REV	
B NO.	LOT + DP		SCALE	A3	DA.9.3	NOT FOR CONSTRUCTION		03