


No	REVISIONS	DRAWN	APPRVD	DATE
A	Draft	DJF		26/1
B	Draft	DJF		1/2
APPROVED			DATE	
			1/2/2020	
SCALE				
1:500 at A3				
TITLE				
Broken Head Reserve Raod Parking / Pedestrian Access Mark-up				
DRAWING STATUS:				
For Community Review				
DRAWING NUMBER:				
BHHR – S2				
REVISION	ORIGINAL SHEET			
B	SIZE			
	A3			

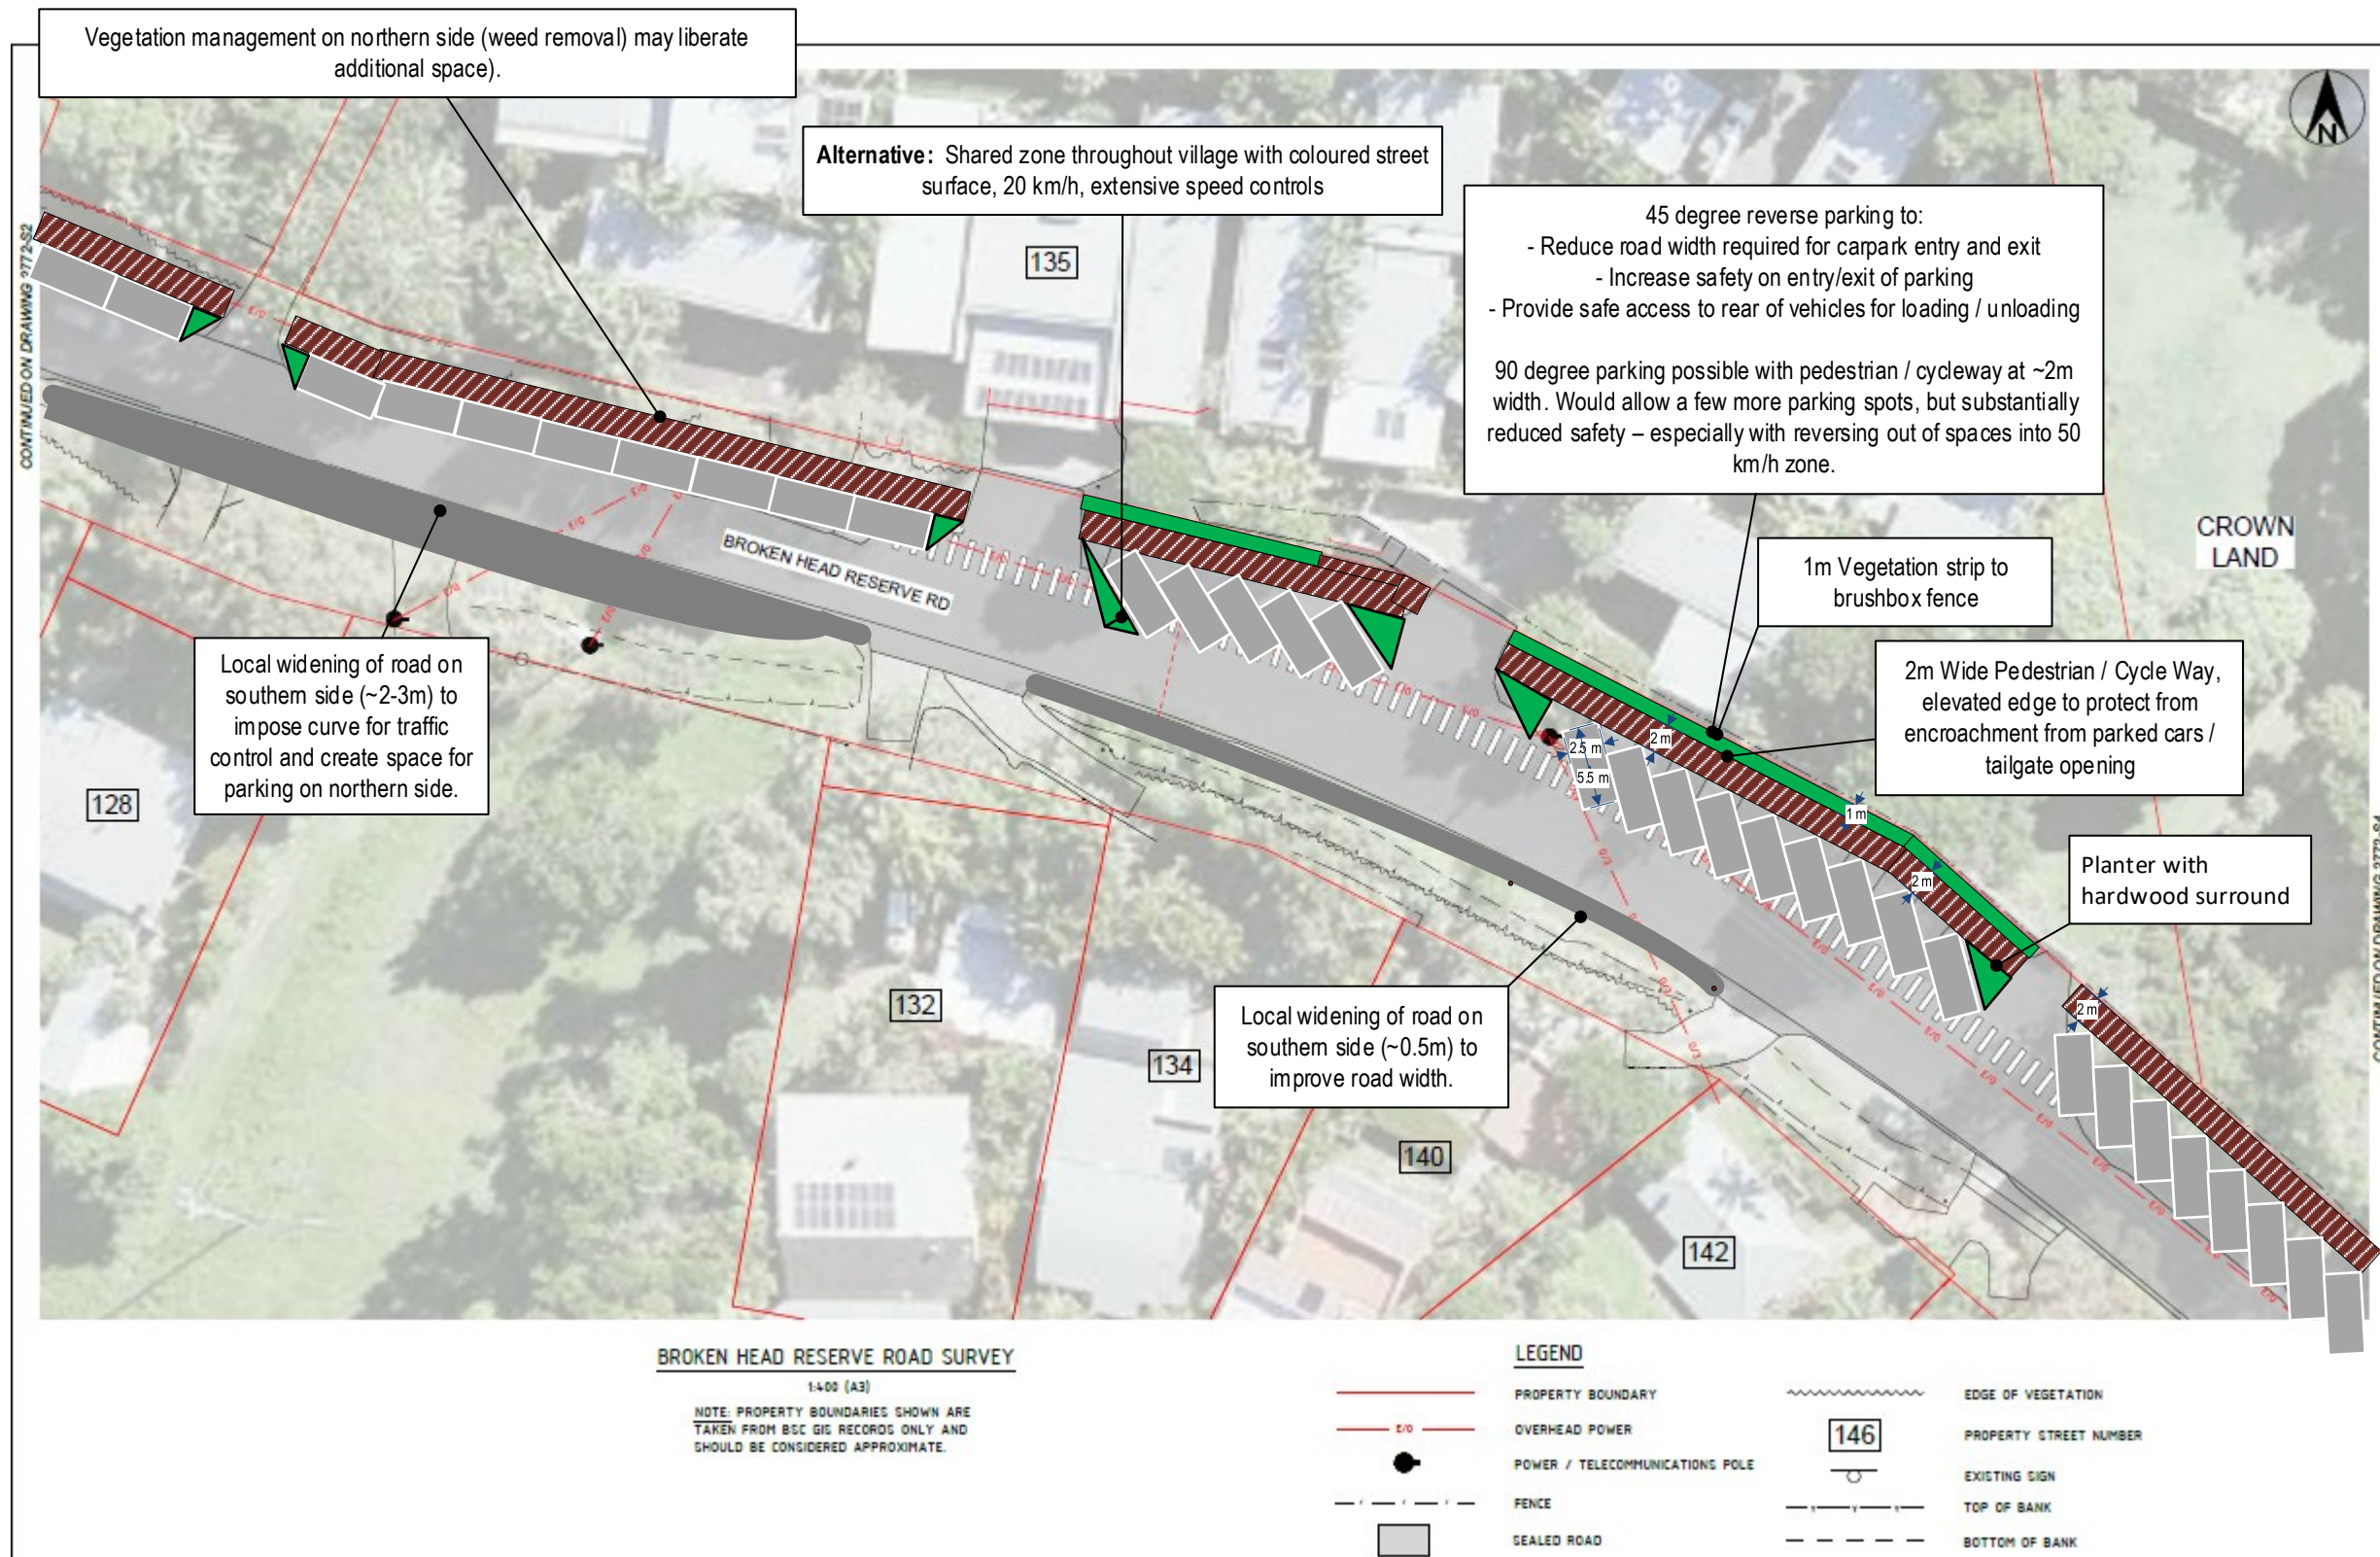

Additional considerations:

- Parking permits for residents' visitors.
- Speed zone review.

0 6 10 20
SCALE: 1:500

No	REVISIONS	DRAWN	APPRVD	DATE
A	Draft	DJF		26/1/20
B	Draft	DJF		1/2/2020

APPROVED	DATE 1/2/2020
----------	------------------


SCALE 1:500 at A3

TITLE Broken Head Reserve Road Parking / Pedestrian Access Mark-up

DRAWING STATUS: For Community Review

DRAWING NUMBER: BHHR – S3

REVISION B	ORIGINAL SHEET SIZE A3	
---------------	------------------------------	--

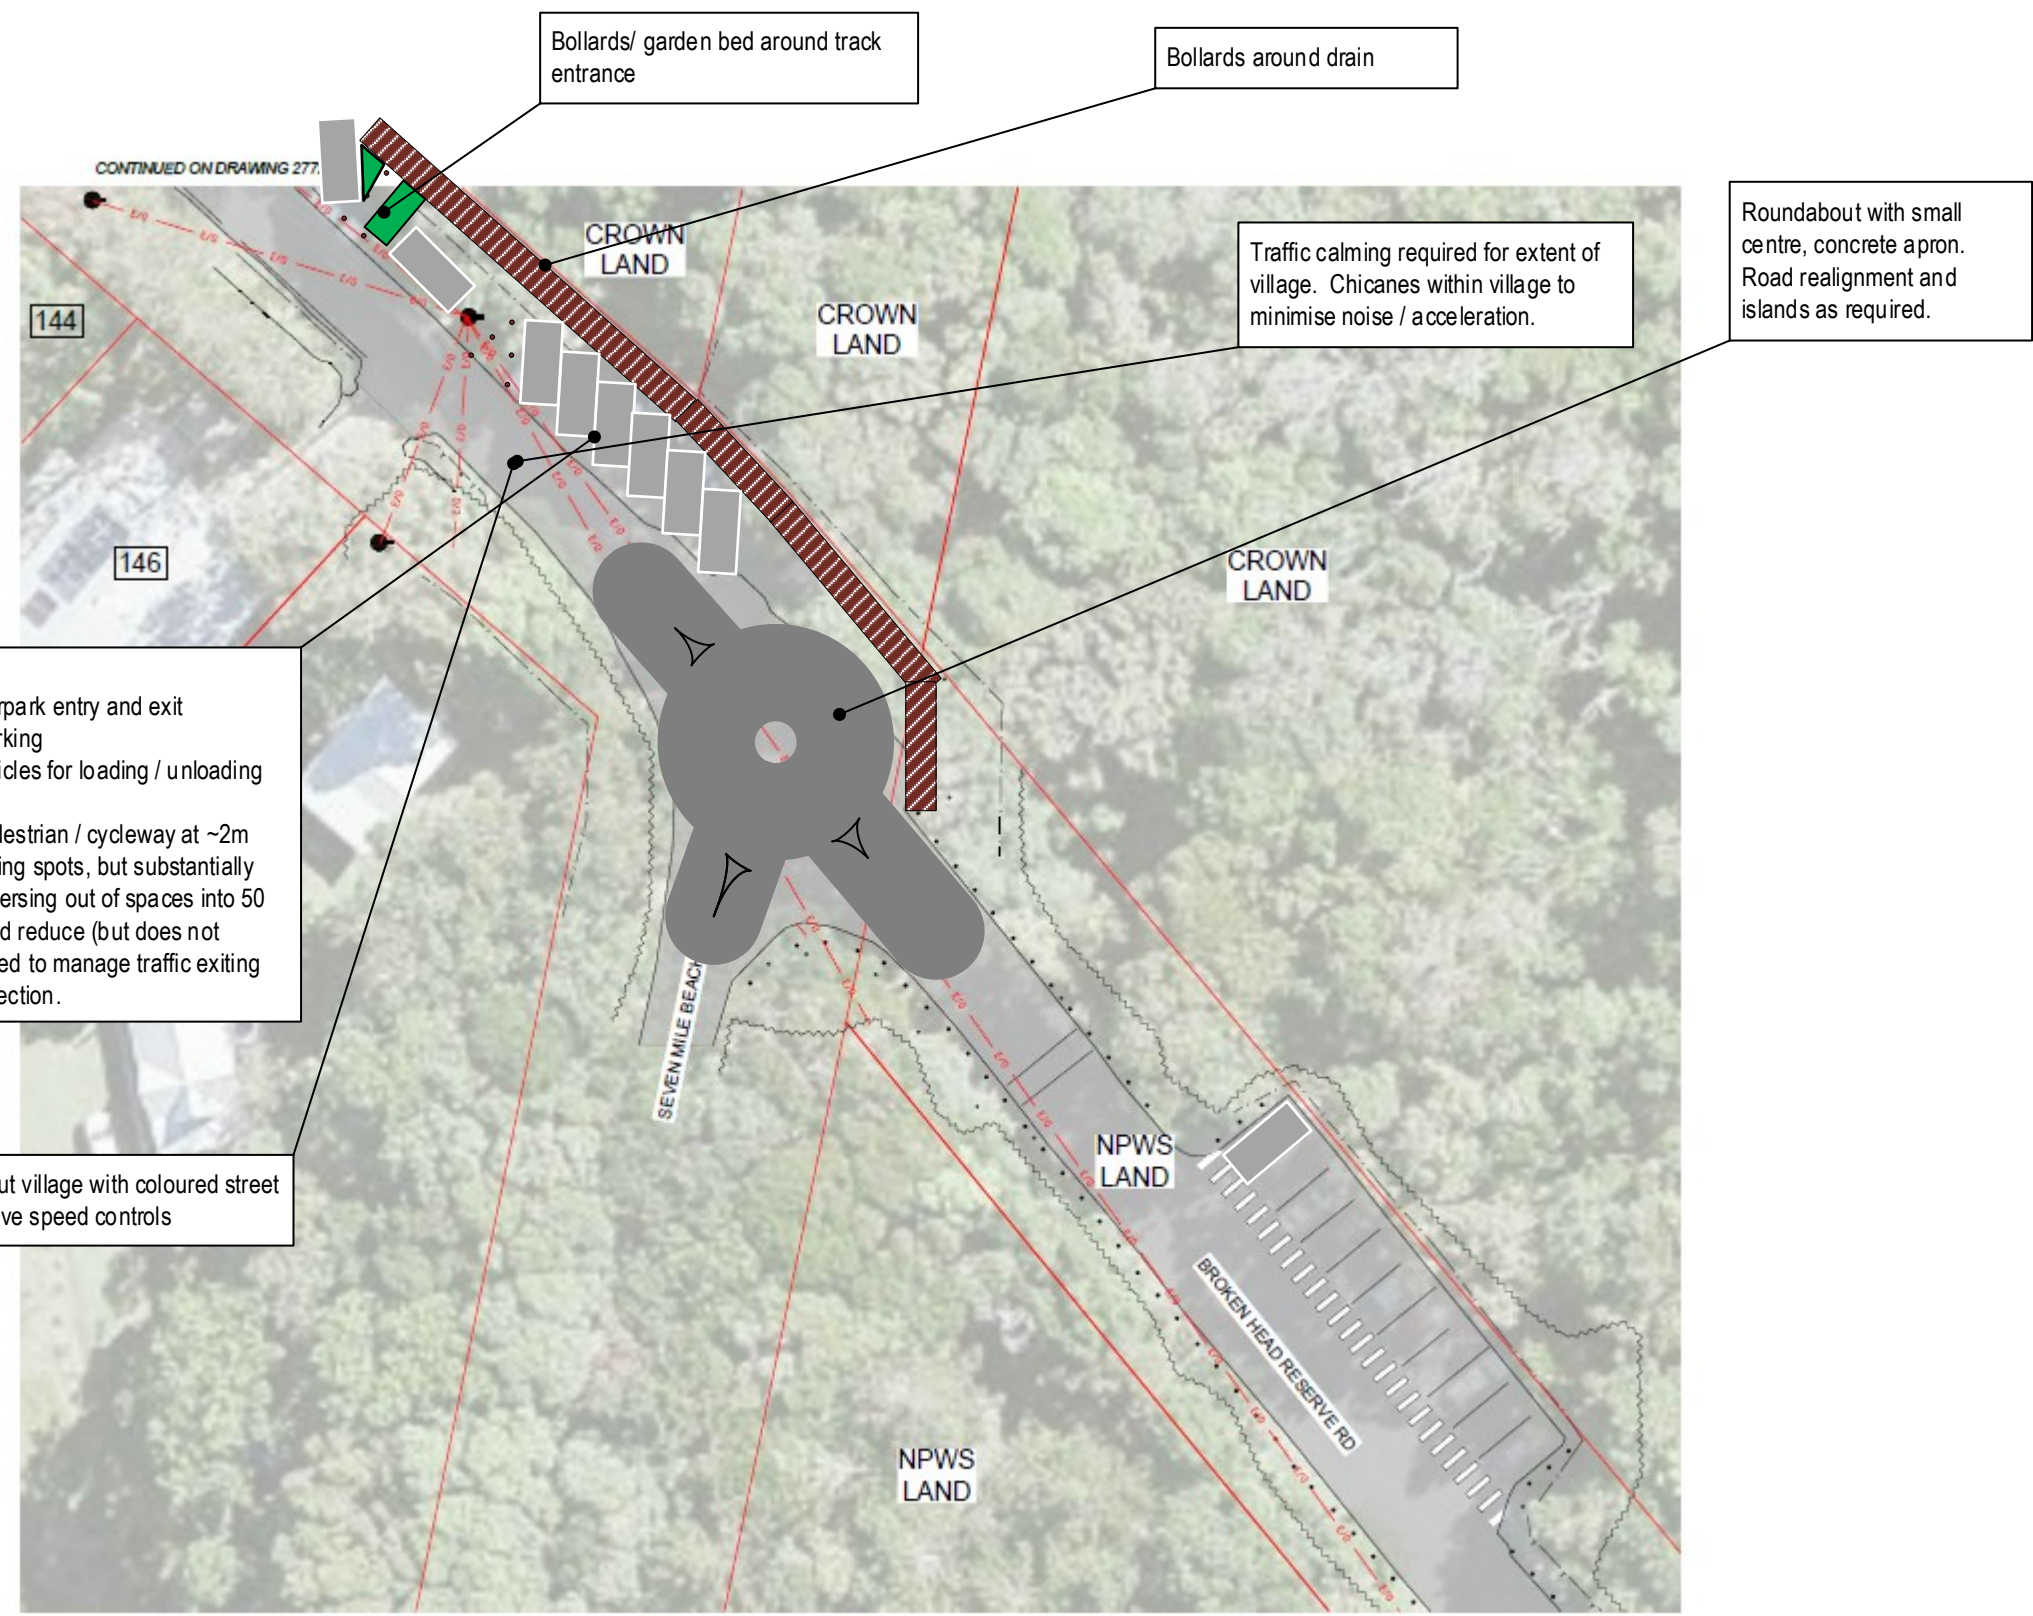

45 degree reverse parking to:

- Reduce road width required for carpark entry and exit
- Increase safety on entry/exit of parking
- Provide safe access to rear of vehicles for loading / unloading

90 degree parking possible with pedestrian / cycleway at ~2m width. Would allow a few more parking spots, but substantially reduced safety – especially with reversing out of spaces into 50 km/h zone. 90 degree parking would reduce (but does not eliminate) need for roundabout. Need to manage traffic exiting from parks in reverse into the intersection.

Alternative: Shared zone throughout village with coloured street surface, 20 km/h, extensive speed controls

Bollards/ garden bed around track entrance

Bollards around drain

Traffic calming required for extent of village. Chicanes within village to minimise noise / acceleration.

Roundabout with small centre, concrete apron. Road realignment and islands as required.

BROKEN HEAD RESERVE ROAD SURVEY
1:400 (A3)

NOTE: PROPERTY BOUNDARIES SHOWN ARE TAKEN FROM BSC GIS RECORDS ONLY AND SHOULD BE CONSIDERED APPROXIMATE.

No	REVISIONS	DRAWN	APPRVD	DATE
A	Draft	DJF		26/1
B	Draft	DJF		1/2
APPROVED			DATE 1/2/2020	
SCALE 1:500 at A3				
TITLE Broken Head Reserve Raod Parking / Pedestrian Access Mark-up				
DRAWING STATUS: For Community Review				
DRAWING NUMBER: BHHR – S4				
REVISION B		ORIGINAL SHEET SIZE A3		

